



As Laid Drainage

Working Together

Martin Cameron

Building Consent Number: *DD007.2021.00043910* Date: *3/1/123* No. of pages:


Building Address: *136 State Highway 26*

Drain Layer Name: *Alan Rawson* [Please print clearly] Signature:

Registration Number: *13490* Business Name: *Rawson Plumbing*

To Council: [Tick]

☒ Hamilton ☐ Hauraki ☐ Matamata-Piako ☐ Otorohanga ☐ Thames-Coromandel ☐ Waipa ☐ Waikato ☐ Waitomo

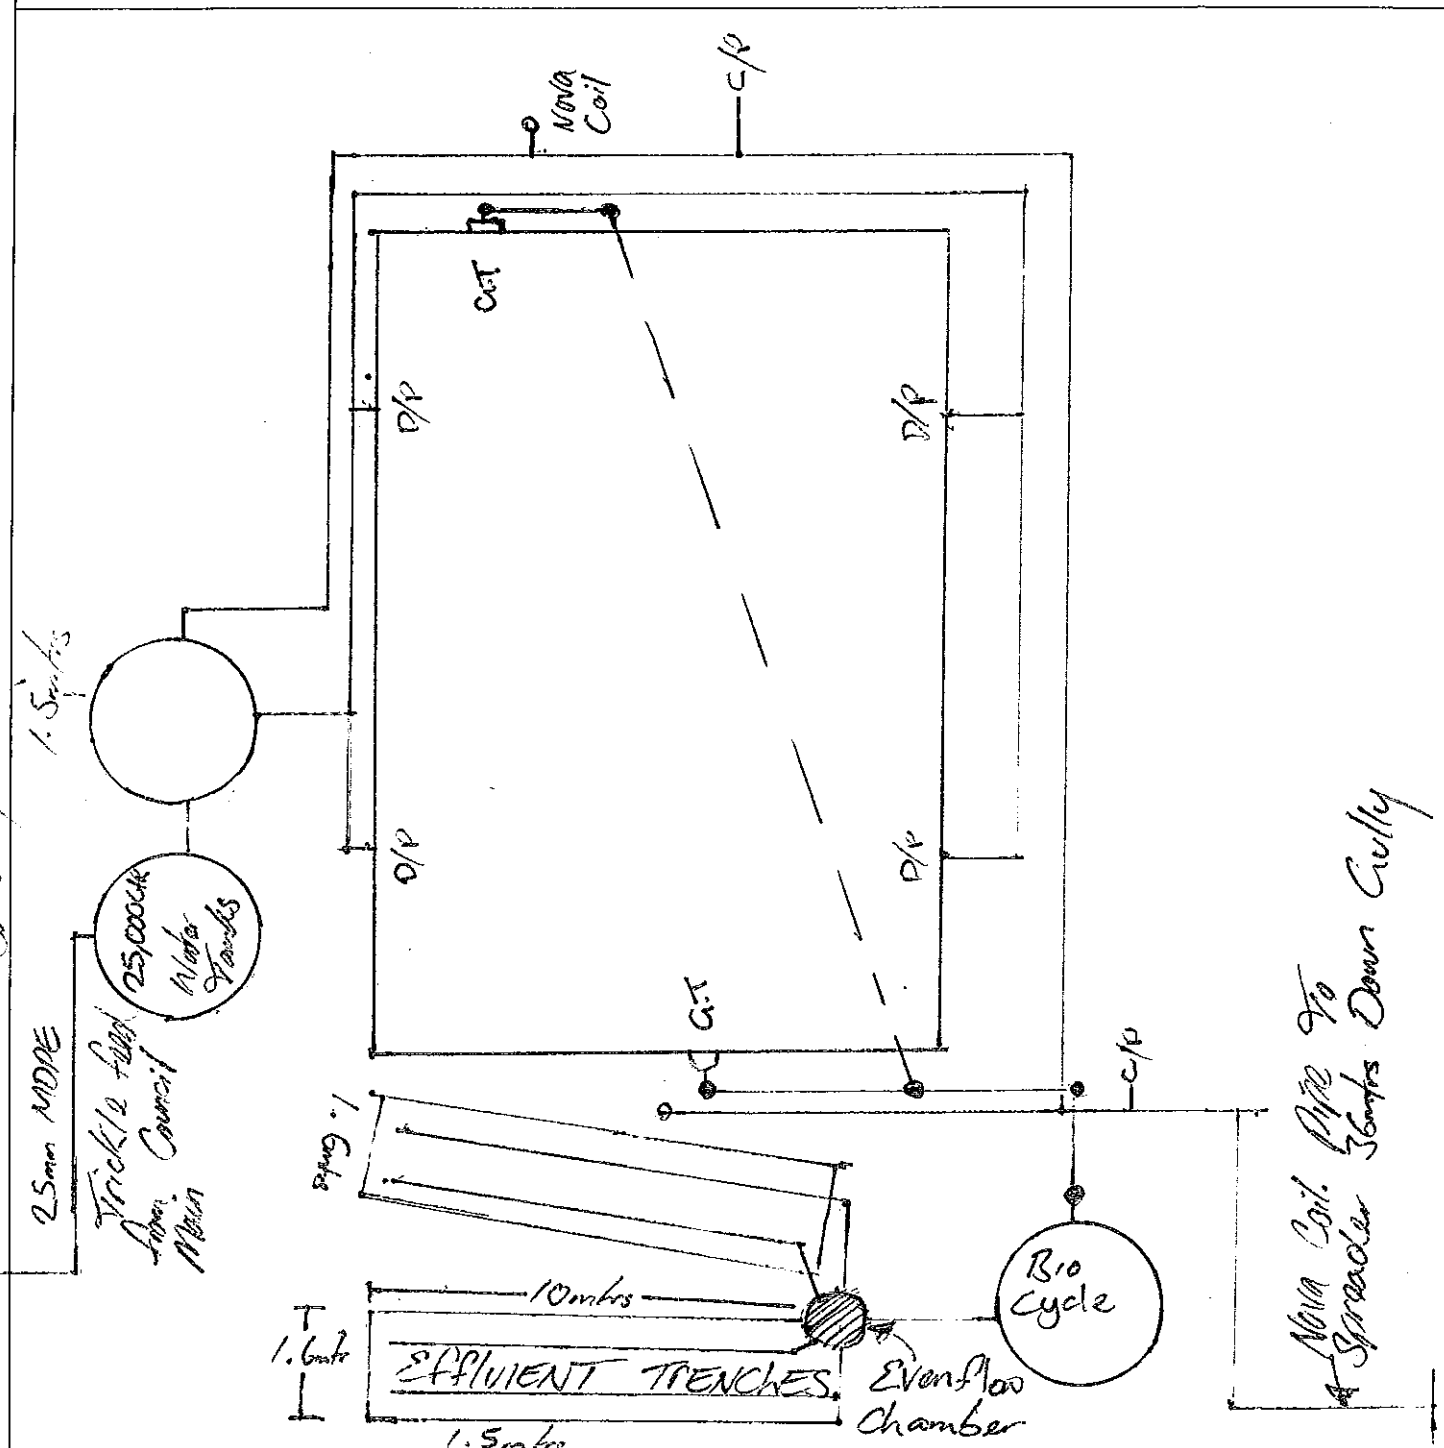

Producer Statement Construction (PS3) / Memorandum of Completion and Compliance

Issued by:
(Construction Reviewer)

GLENN RAWSON

Building Consent number:

43914

Company Name:

RAWSON PLUMBING

To: ☒ Hamilton City Council ☐ Hauraki District Council ☐ Matamata-Piako District Council ☐ Otorohanga District Council
☐ Thames-Coromandel District Council ☐ Waikato District Council ☐ Waipa District Council ☐ Waitomo District Council

Waikato Building Consent Group Reg. No.:

Expiry Date:

Other No. (specify):

Owner:

MARTIN CAMERON

Project Address:

136 State highway 26

Lot:

DP:

Description of Building Work:

DRAINAGE / SEWER + STORMWATER

Scope of work covered by statement:

System / Product used (if applicable):

I (Construction Reviewer's name):

GLENN RAWSON

have been engaged by (owner/developer/contractor):

In respect of (tick applicable):

☒ The requirements of the Building Regulations 1992, Clause(s): (Please be specific e.g. E2.3.5)

G13

☐ Alternative Solution(s):

for the building work described by the drawings and specifications prepared by the design firm titled:

numbered:

☐ Copies attached

authorised amendments(s):
(if applicable)

☐ Copies attached

- ☐ I have sighted the Building Consent and read the Advisory Notes. I can confirm that the building works have been carried out in accordance with the requirements of the New Zealand Building Code, the Building Consent, the design drawings and specifications, and in accordance with the listed amendments (if any).
- ☐ I confirm that all work I have undertaken has been within the scope of my skills, knowledge, and experience. I have remained within the scope of works set for me by the *Waikato Building Consent Group Producer Statement Author register (if applicable).
- ☐ I understand that this Statement, if accepted, may be relied upon for the purpose of establishing compliance with the Building Code and the Building Consent.
- ☐ I am satisfied the building work complies with the requirements of the Building Consent and the New Zealand Building Code.

Signed by
(Construction Reviewer):



Name of Constructor
(Print clearly):

GLENN RAWSON

Date:

Address:

Ph:

07 871 4671

Mb:

Fx:

Email:

Qualifications
/ Experience:

CERTIFYING PLUMBER GASFITTER DRAINLAYER.

*The Waikato Building Consent Group Producer Statement Author register is held by the Waikato Building Consent Group,
Email: info@buildwaikato.co.nz For information on the Waikato Building Consent Group visit the [Build Waikato](https://www.buildwaikato.co.nz) website.